









TRANSFERRED TO:  
L. R. SYSTEM

General Arrgt - Profile

2/3 SOUTHERN LILY


Middlebro 27.12.17.

S. L. "Southern Laurel" ★

TO ACCOMPANY *Mdb.* REPORT No. 18431

DATED *April 1949*

RECORDS DEPT.,  
LONDON

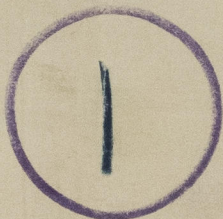

G.A.(1)  
S. Lily

004693-004697-0271



© 2020

Lloyd's Register  
Foundation



TRANSFERRED TO:  
L. R. SYSTEM

General Argt. - Profile


S. SOUTHERN LILY

Middlebrough 27.12.47.

S. S. "Southern Lilies" ★

TO ACCOMPANY	Middb.	REPORT No.	18431
DATED	April 1949		

RECORDS DEPT.  
LONDON

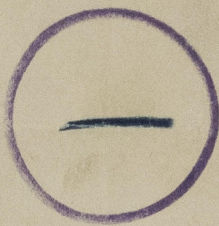

General Argt.  
S. Southern Lily

Middlebrough

26 DEC 1947

S. a. l. i.  
S. Lily



© 2020

Lloyd's Register  
Foundation

004693-004697-0271






26 DEC 1947

SS "SOUTHERN LILY"  
EX HMS RANUNCULUS

Call: 27-12-47


 


RED LINE INDICATES  
ORIGINAL FORECASTLE

NEW FORECASTLE FRONT  
PLATE  
STEPS 5X11-33 L TO FOUNDATION L TOP & BOTTOM  
2H COATING OPENING 4'-0" X 2'-0"  
WITH STRONG WOOD DOOR  
SOLE 7'-0" HIGH  
SEE PLAN VIEW

THE ABOVE ALTERATION APPLIES TO  
SOUTHERN LILY ONLY "SOUTHERN LOTUS" FORECASTLE REMAINS  
AS SHOWN IN RED

5/8" SOUTHERN LILY  
EX 5/8 RANUNCULUS  
GENERAL ARRANGEMENT PROFILE  
SCALE 1/4" = 1 FOOT

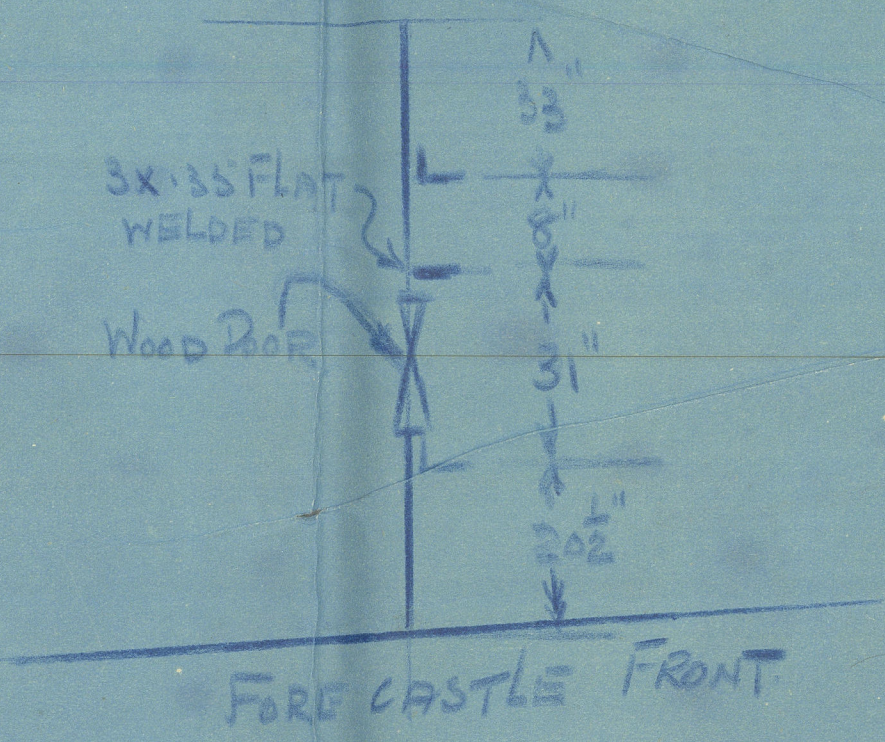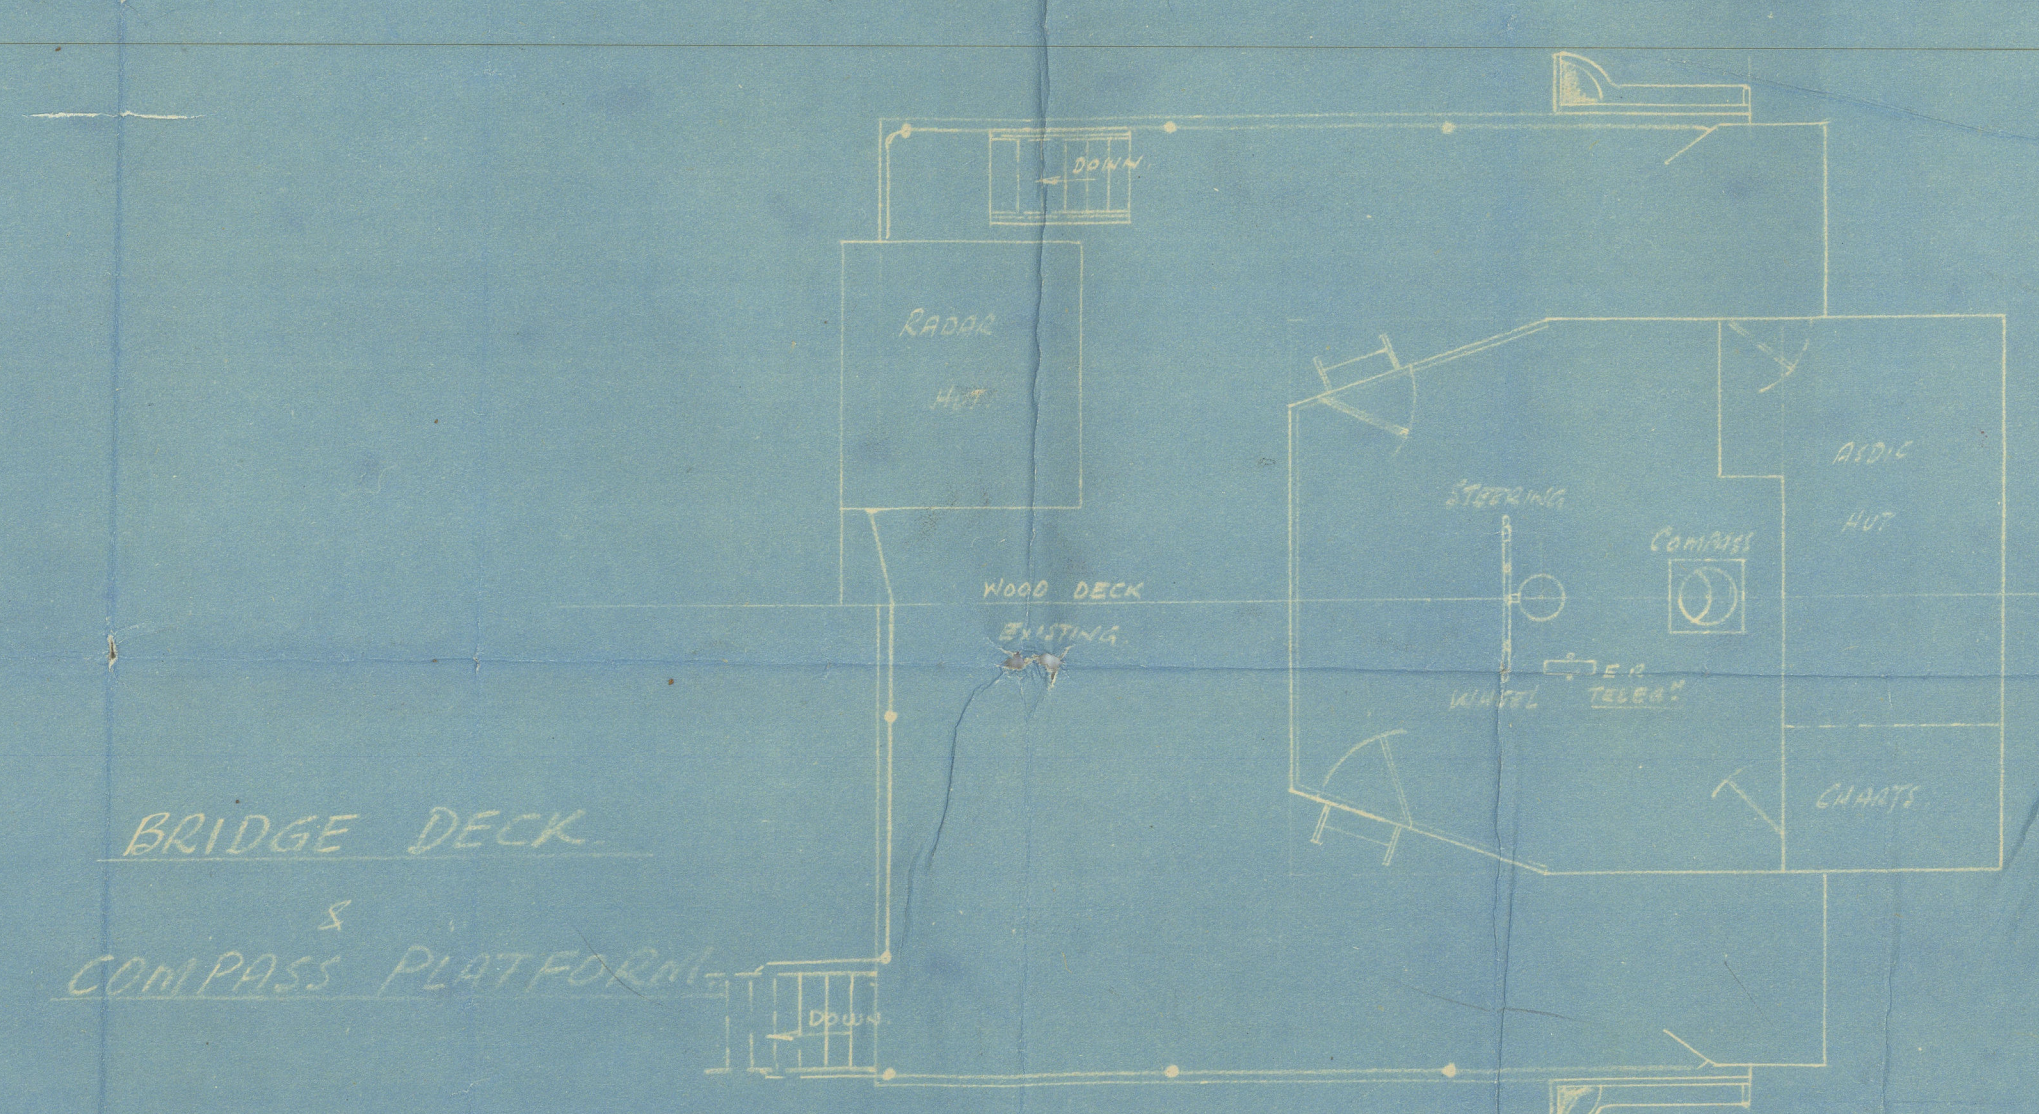

SOUTHERN LILY  
TO ACCOMPANY M108 REPORT No. 18731  
DATED April 1949

See "Flower" class sonnette









2

TRANSFERRED TO:  
L. R. SYSTEM

General Airtel - Decks

S. S. SOUTHERN LILY

Middlesbro 27.12.47.

S. S. "Southern Laurel" ★

TO ACCOMPANY	<i>mal.</i>	REPORT No. <i>18731</i>
DATED	<i>April 1949</i>	

RECORDS DEPT.:  
LONDON

2



© 2020

Lloyd's Register  
Foundation



General Bragt.

6/5 Southern Lily

Middlesbrough

26 DEC 1947

Bag

B. Corp. M. Bro

Middlesbrough

004693-004697-0272



© 2020

Lloyd's Register  
Foundation





*Handwritten:* S.S. Southern Lily  
ex HMS Ranunculus

**S.S. SOUTHERN LILY**  
**EX HMS RANUNCULUS**

26 DEC 1947



**S.S. "SOUTHERN LILY"**

**EX S.S. "RANUNCULUS"**


**GENERAL ARRGT**

**SCALE 1/4" = 1 FT**

**CASING TOP**

  

**UPPER DECK**

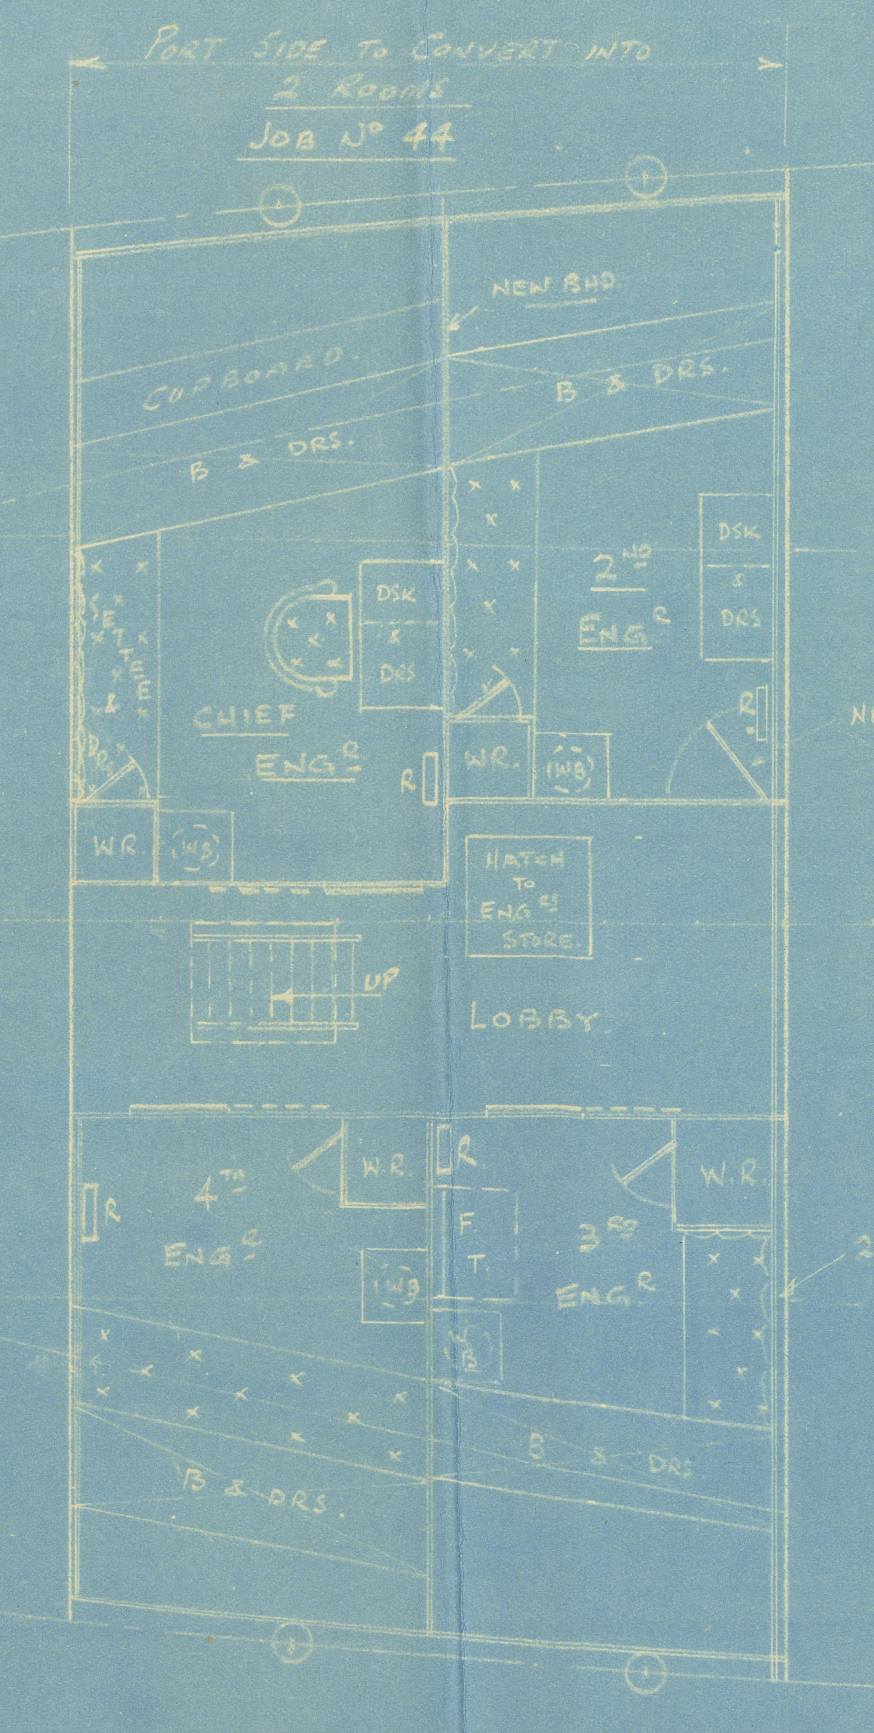

**CABIN FLAT**


**ORIGINAL FORECASTLE END**

**ORIGINAL FORECASTLE CUT BACK TO THIS LINE**

**COMINGS TO BE REMOVED + BOLTED PLATES FITTED PFS**

**NOTE:**

EXISTING MECHANICAL VENTILATION TO BE MODIFIED TO SUIT NEW ARRGT.

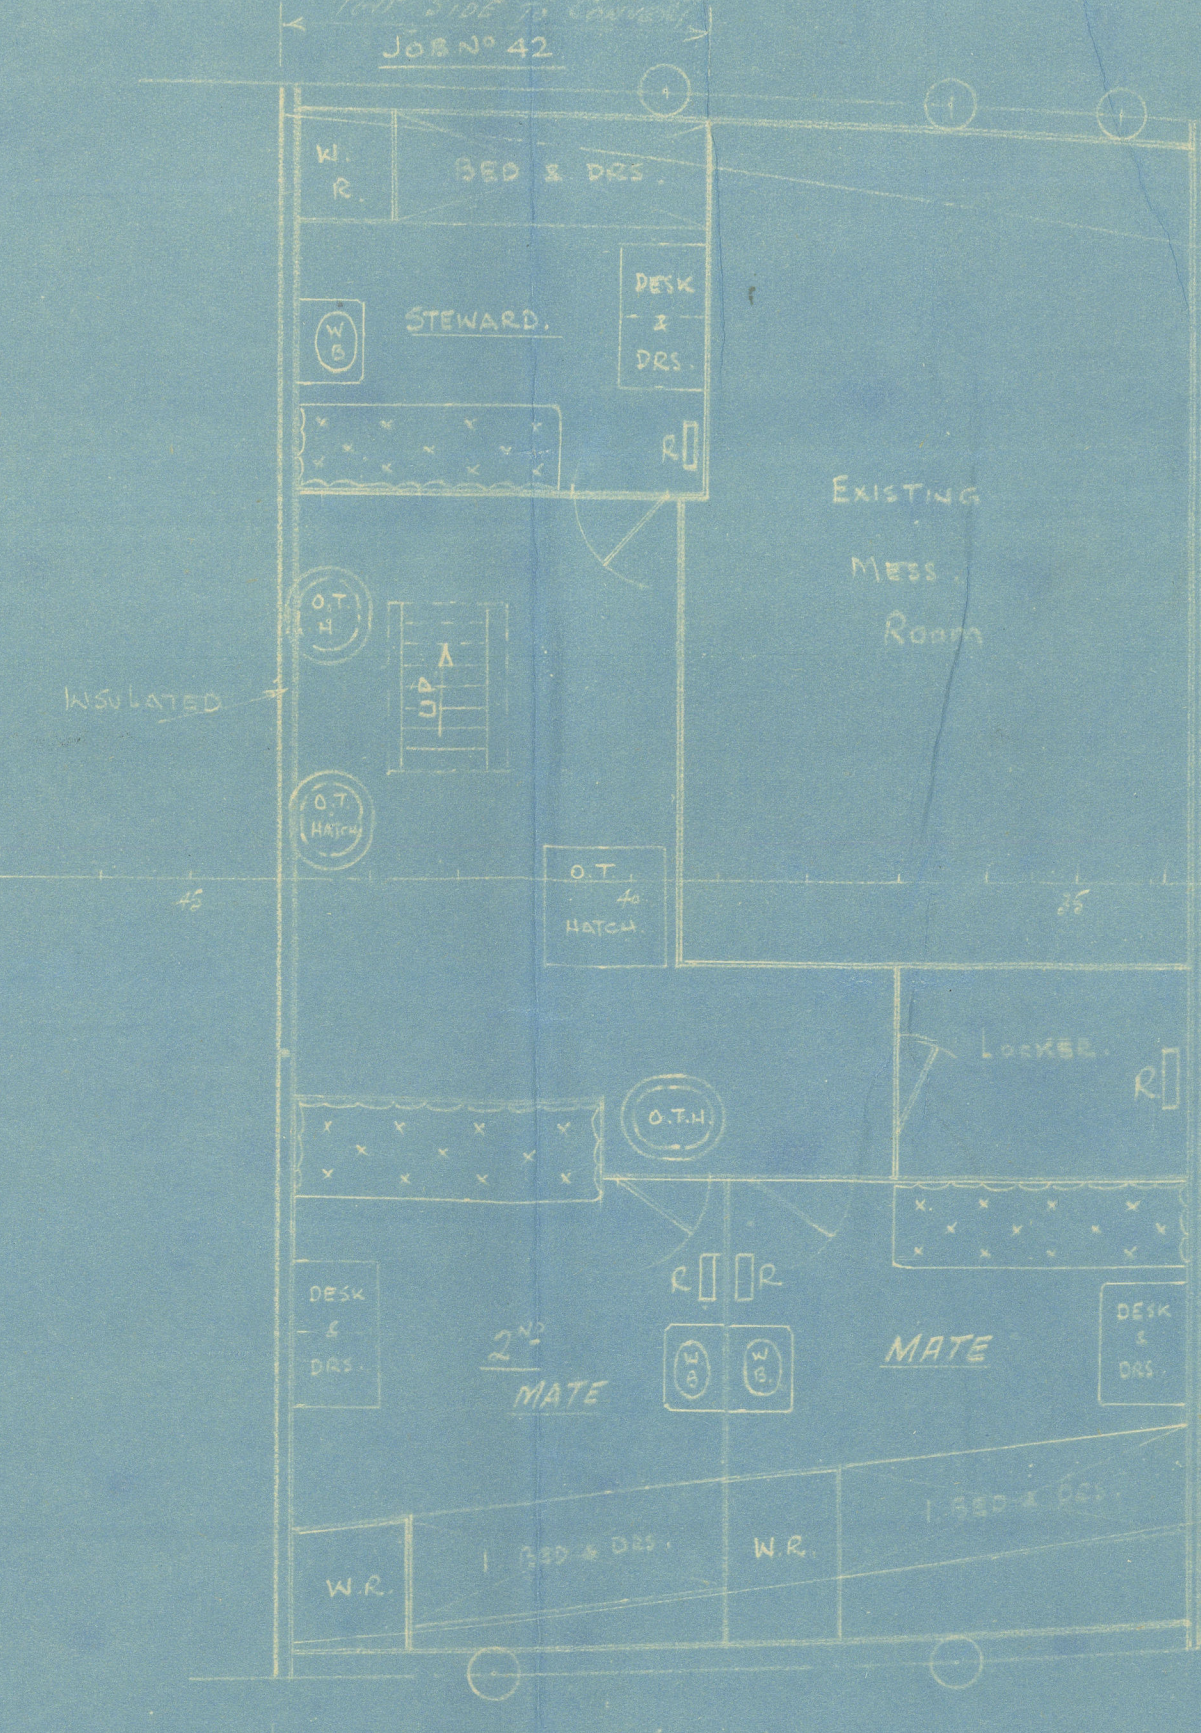

**S.S. "SOUTHERN LAUREL"**  
TO ACCOMPANY **W.D.B. REPORT No. 12731**  
DATED **April 1949**  
*by "Hawes" class Corvettes*



Ventilators

of Southern Lely  
& Southern Lotos

---

Bag



© 2020

Lloyd's Register  
Foundation



# VENTILATORS AS FITTED ON "SOUTHERN DALLI" + "SOUTHERN LOTUS"

DETAIL OF FRENCH TYPE  
VENTILATORS - EXHAUST -

8" SUPPLY COWL VENT  
TO CREW ACCOM.

2" AIR PIPE TO FORE PEAK

1/4" SUPPLY  
CREW MESS.

'X'

'Y' FORWARD IN ALL  
CASES.

EXHAUST VENT. TABLE

SIZE	A	B	C	D	E	F	G	H	J	K	DRP.	NOS OFF
4"	4"	1 3/4"	8"	4"	3 1/2"	4"	3"	1 3/4"	1"	3 @ 1"		AS
6"	6"	2 1/4"	10"	8"	4 1/2"	8"	4"	2"	1"	5 @ 1"		PER
8"	8"	3"	13"	10 1/2"	5 1/2"	11"	5"	2 1/2"	1 1/2"	5 @ 1"		PLAN

HOODS TO BE OF 5 LBS. 7/8" PLATE

THE OPENING EXPOSED TO WEATHER

IS TO FACE AFT IN ALL CASES

SEE DETAIL FOR MAGAZINES & SPIRIT ROOM

UPPER DECK


2" AIR PIPE TO CHAIN LOCKER

'K' DRAIN HOLES.

2" AIR PIPE TO FORE PEAK

TRUNK VENT SUPPLY  
TO CREW ACCOM.

D

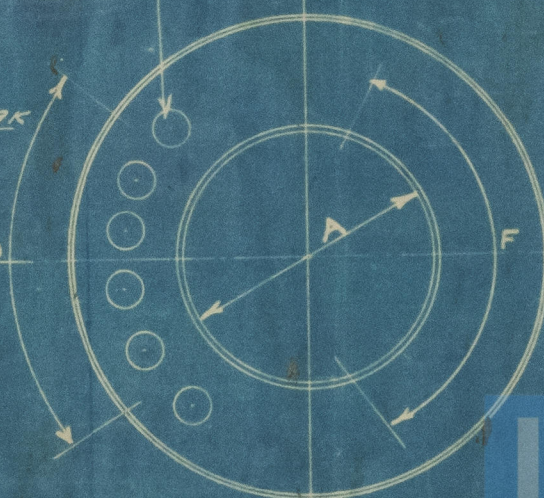

SECTION 'X' - 'Y'



© 2020

Lloyd's Register  
Foundation

004693-004697-0272-1